




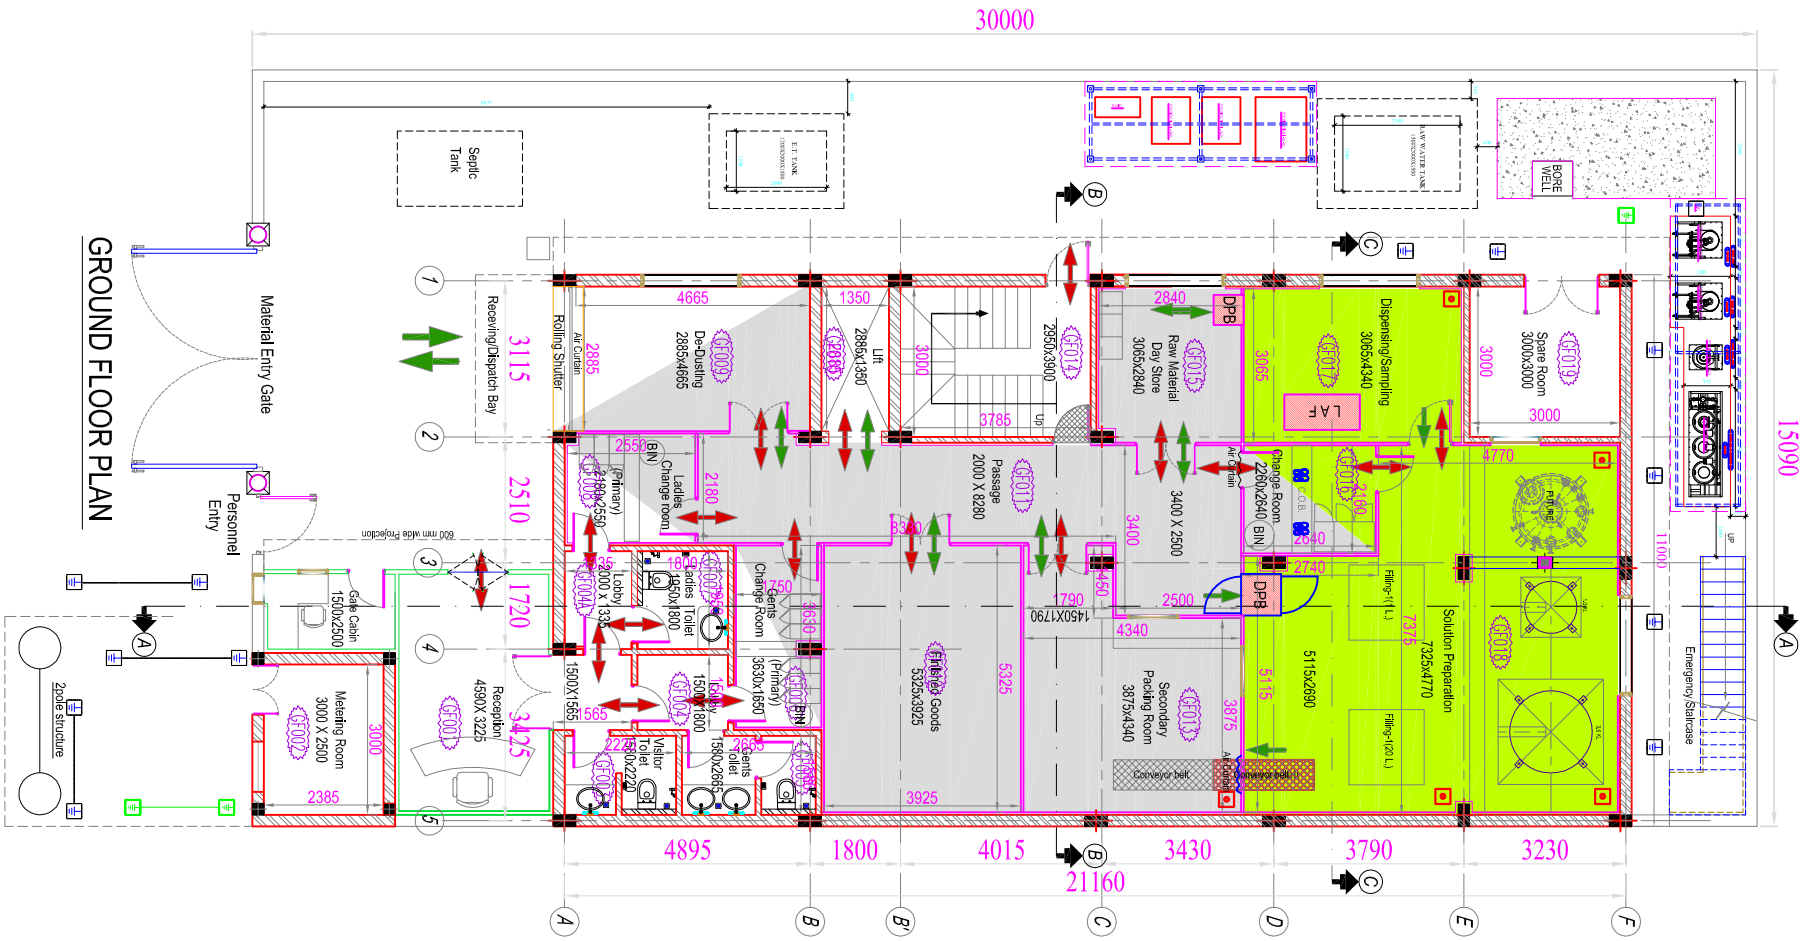

GROUND FLOOR PLAN

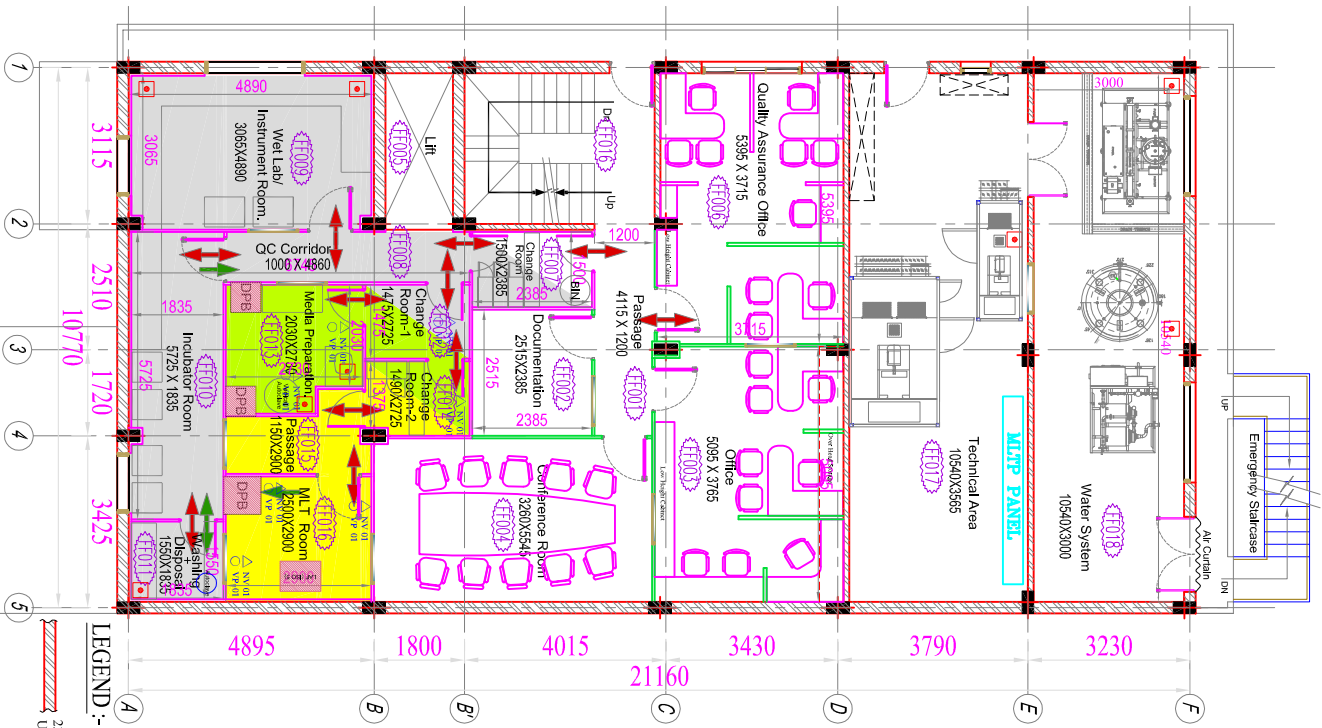

FIRST FLOOR AT+3.35 M.LVL

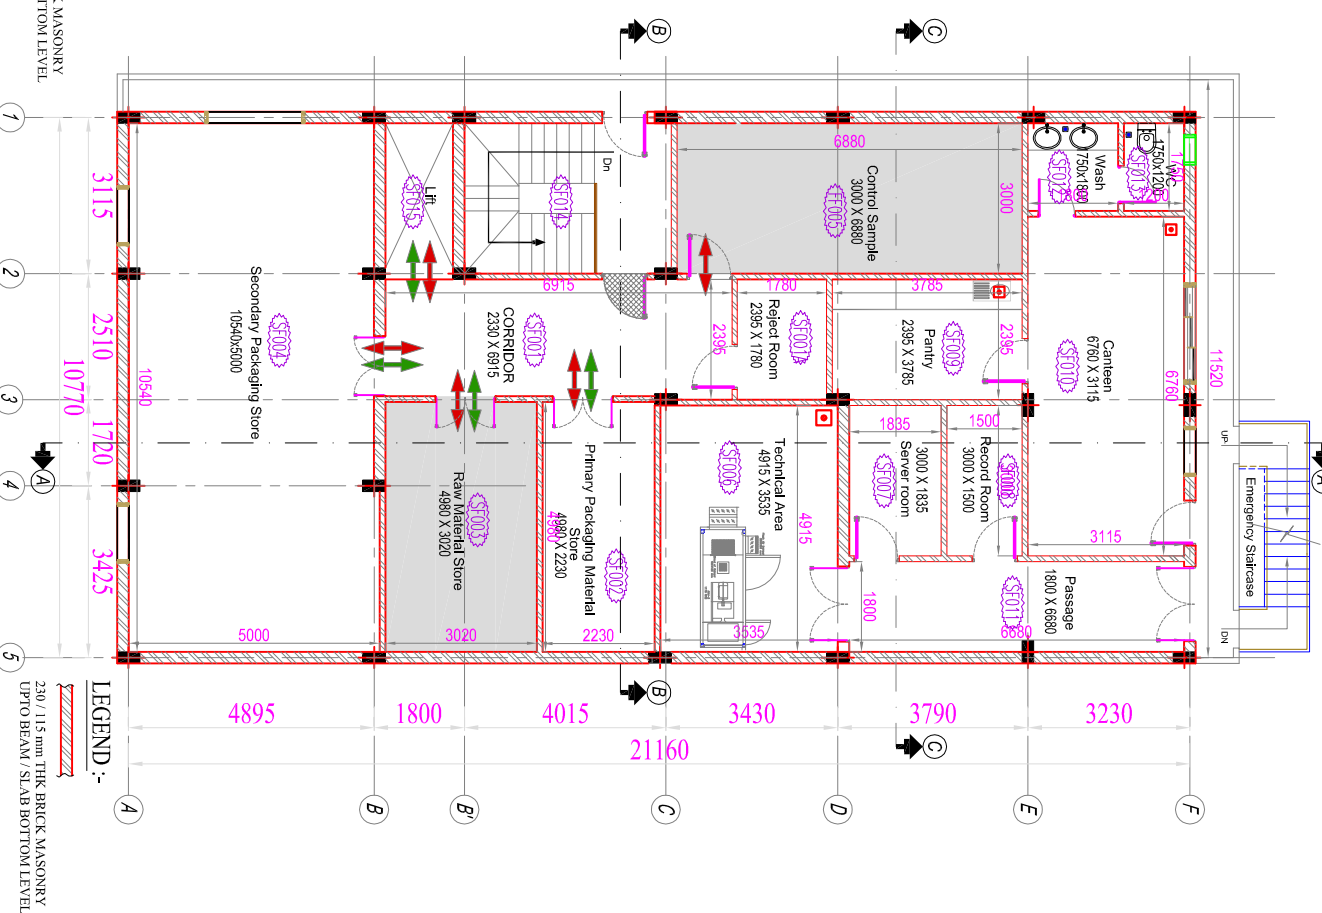

SECOND FLOOR AT+6.70 M.LVL

LEGEND

- ISO-8 (In-operation) / Grade - "C"
- ISO-8 (At Rest) / Grade - "D"
- CNC (Controlled not Classified)
- ISO-5 (In-operation) / Grade - "A"
- Personnel Movement
- Material Movement

AS BUILT

Rev.no.	Date	Revised by	Checked by	Approved by	Description of Revision	Issued Through	Date	Issued to
1	16.06.2014	SP	AS	RS	ALL FLOOR PLANS			
2	16.06.2014	AS	RS					
3	16.06.2014	RS						
4	16.06.2014	RS						
