


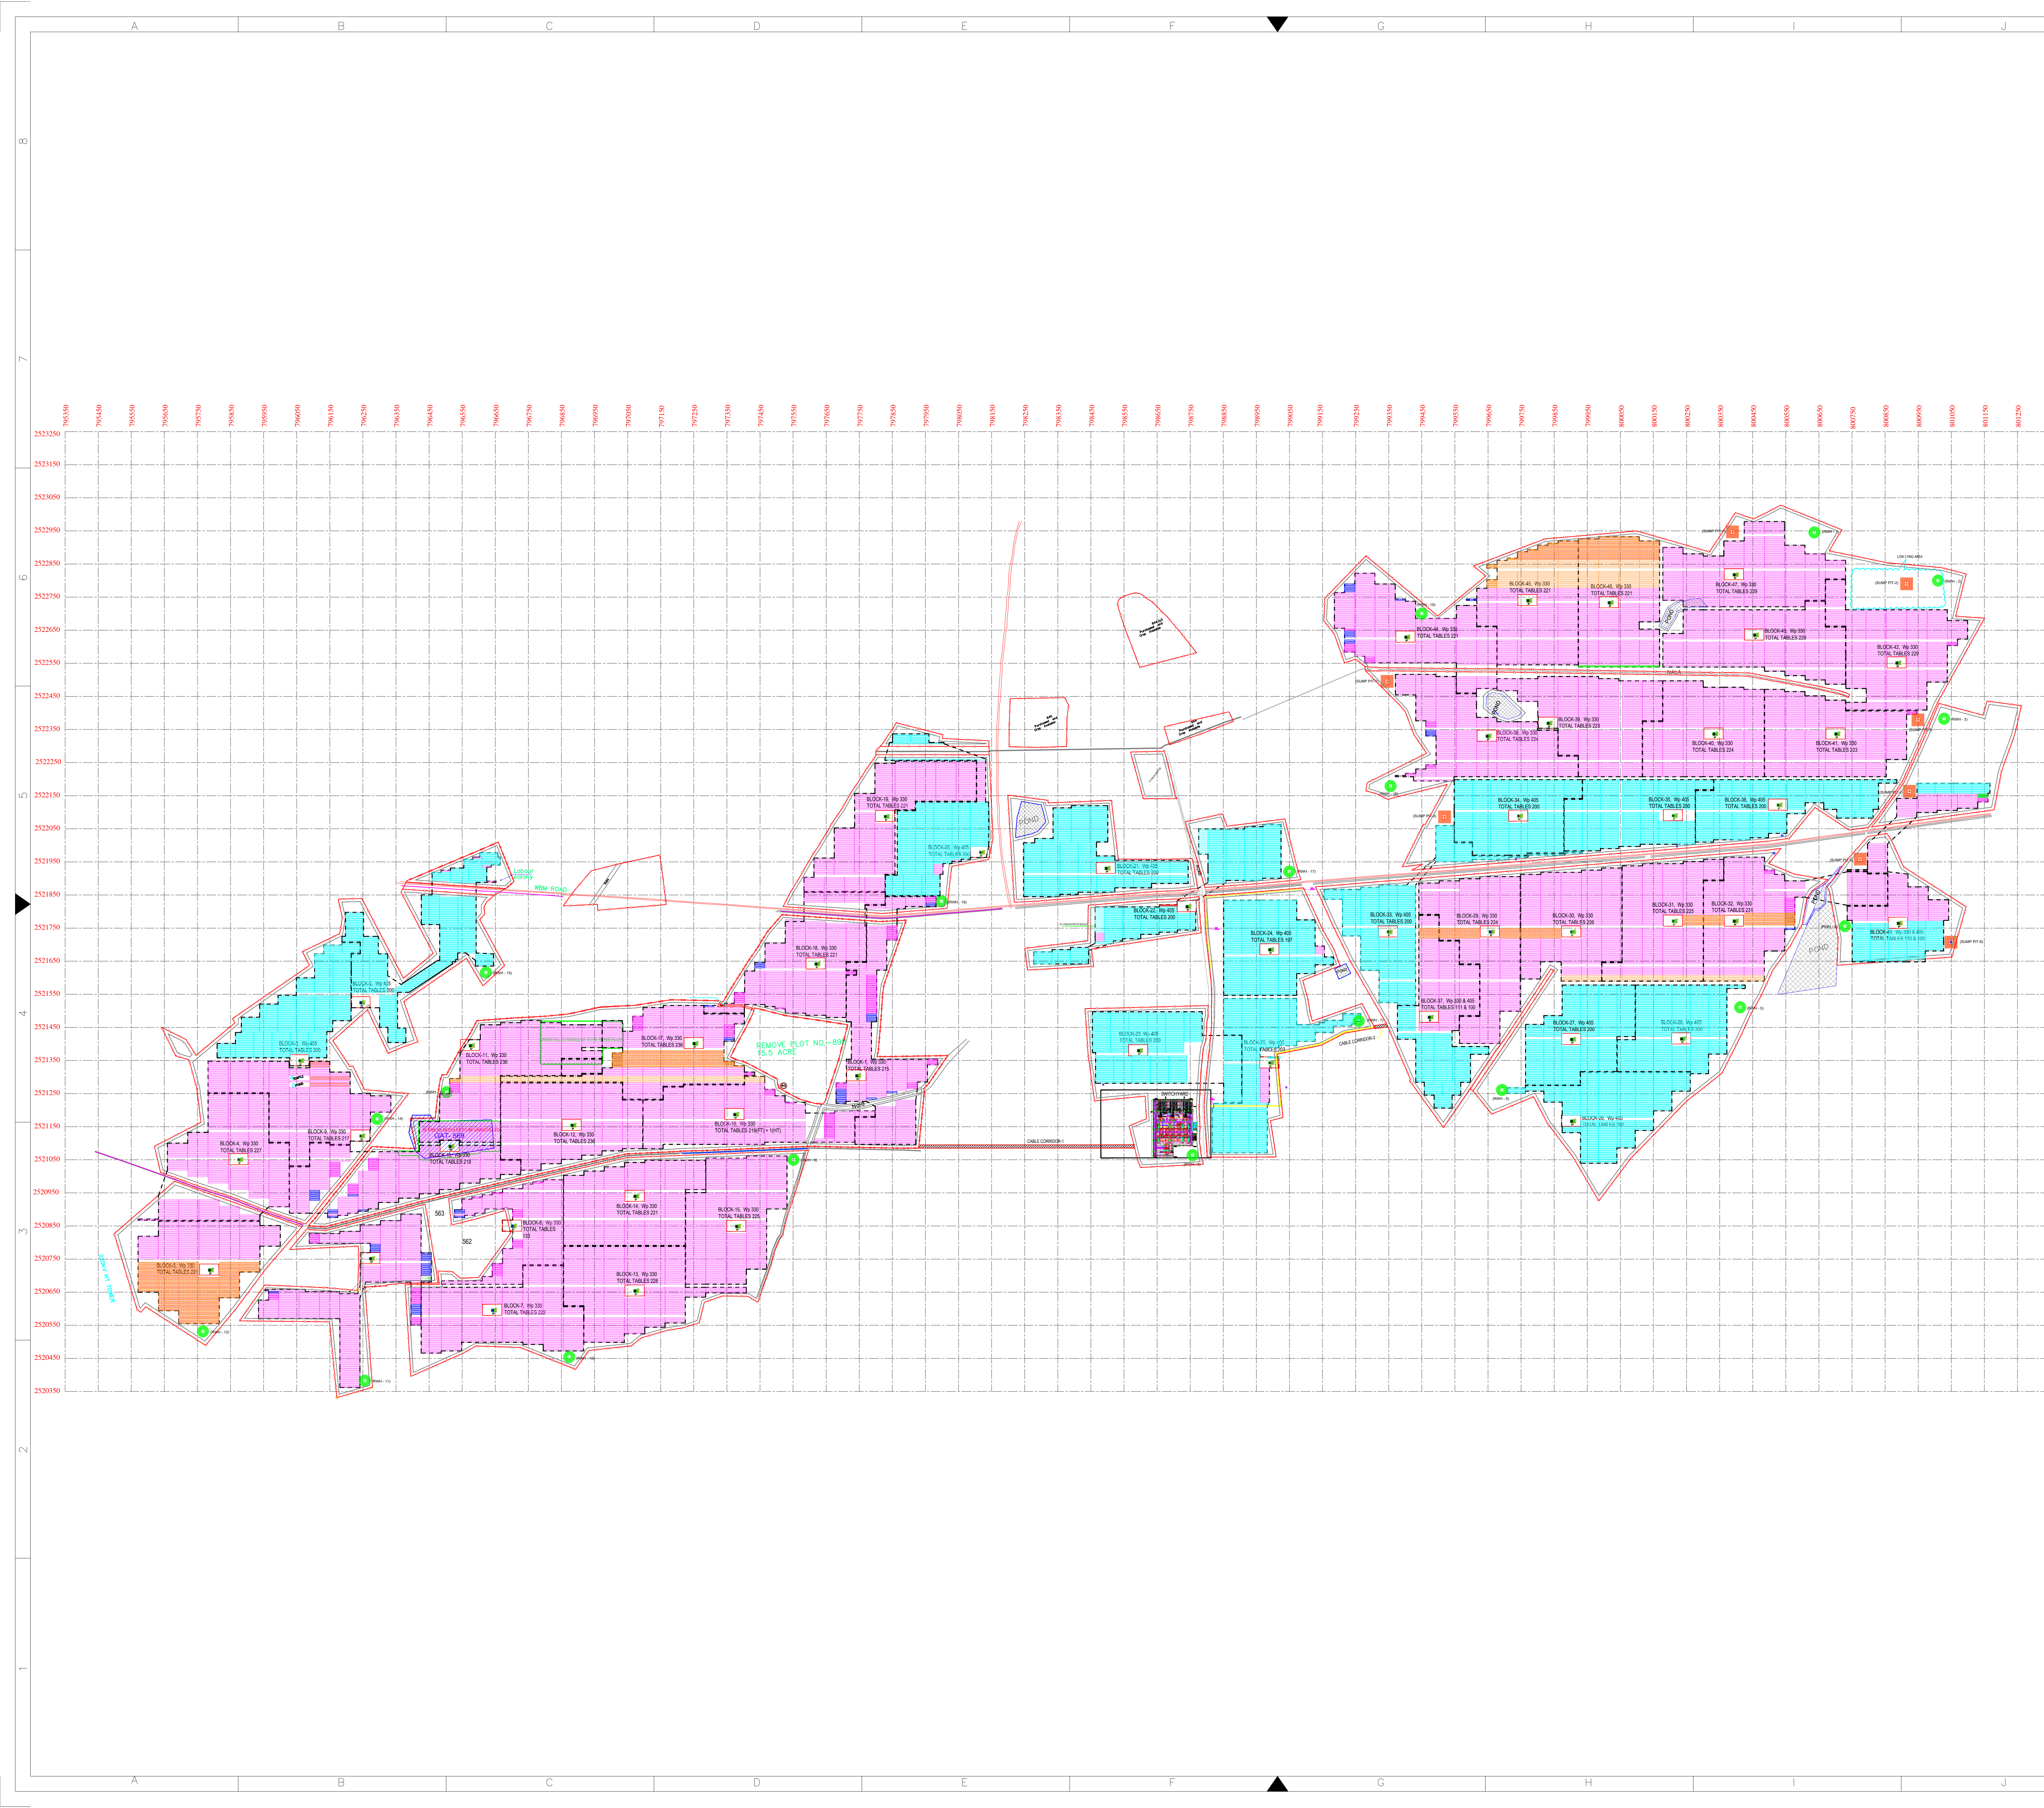

1. ALL DIMENSIONS AND LEVELS ARE IN METER. UNLESS NOTED OTHERWISE.
2. THE PLANT LAYOUT PREPARED CONSIDERING SHADOW FREE TIMING 8.00 TO 5.00pm.
3. DISTANCE BETWEEN 2 TABLES IS 0.750 M UNLESS OTHERWISE NOTED.
4. PLANT SUMMARY:

LEGEND

PERIPHERAL BOUNDARY: 

FENCING BOUNDARY: 

OFFSET LINE: 

RISEN MODULE TABLE: 

JA SOLAR MODULE TABLE: 

WAREE MODULE TABLE: 

19	07-10-22	MODULE RELOCATION INCORPORATED IN BLOCK 10 & 11	DKP
18	21-12-21	PLANT LAYOUT REVISED AS PER MODULE DISTRIBUTION	DKP
17	19-07-21	PLANT LAYOUT REVISED AS PER SITE INPUT	DKP
16	25-05-21	2 HALF TABLES ADDED IN BLOCK NO.-2	DKP
15	24-05-21	BLOCK-2,6,8,18,29,30,31,32&35 REVISED AS PER SITE INPUT	DKP
14	24-06-21	REVISED BLOCK-4,6,8,11,12,15,17,29,30&37 AS PER SITE AS BUILT	DKP
13	24-03-21	PLANT LAYOUT REVISED AS PER SITE INPUT, BLOCK-24 & 25 REVISED	DKP
12	11-02-21	REVISED BLOCK-1,6,7,10,11,13,16,17,21,22,26 to 28, 32,33, 38 to 43, 47&48 AS PER SITE AS BUILT	DKP
11	12-12-20	PLANT LAYOUT REVISED AS PER SITE INPUT	DKP
10	09-12-20	PLANT LAYOUT REVISED AS PER SITE INPUT	DKP
9	01-12-20	BLOCK-1 TO 19 REVISED AS PER SITE INPUT	DKP
8	12-11-20	BLOCK-2,11,17,18 & 19 REVISED AS PER SITE INPUT	DKP
7	13-10-20	BOUNDARY REVISED & BLOCK-2,3,20 TO 28,33 TO 36 & 48 REVISED AS PER SITE AS BUILT, BLOCK-29 TO 32 BOUNDARY REVISED	DKP
6	17-09-20	BOUNDARY REVISED & BLOCK-2,3,20 TO 28,33 TO 36,41,42 & 48 REVISED	DKP
5	15-06-20	BOUNDARY REVISED & BLOCK-20 TO 25, 33 TO 40 REVISED.	DKP
4	06-06-20	2 TABLES RELOCATED IN BLOCK-15, BLOCK 2,3, 20 TO 28, 33 TO 36 & 48, REVISED AS PER NEW 385/390 Wdg MODULE	DKP
3	05-03-20	BOUNDARY REVISED & BLOCK-1, BLOCK-48 RELOCATED	DKP
2	11-02-20	VERTICAL ROAD NEAR BLOCK-16 REMOVED	DKP
1	31-01-20	BLOCK NO 26-36 & 38-48 RELEASED	DKP
0	29-01-20	BLOCK NO 01-16 RELEASED	DKP

PROJECT TITLE:	300 MW SURENDRANAGAR SOLAR POWER PROJECT AT GUJARAT
----------------	---

CUSTOMER :	AVAADA SUNRISE ENERGY PVT LTD
------------	----------------------------------

DRAWING NO :	ASESG1-AEL-601-LYO-0100	SCALE	NTS
--------------	-------------------------	-------	-----

DRAWN	DKS	SHEET NO	10F1
CHECKED	NS	PAPER SIZE	A0
REVIEWED	SS		
APPROVED	SM		
DATE	07-10-22	REV NO.	19