This drawing and the design are the property of STERLING AND WILSON LTD., they will not be reproduced,copied loaned exhibited nor used except in limited way and private use permitted by any written consent

	START		END	
	X COORDINATES	Y COORDINATES	X COORDINATES	Y COORDINATES
CABLE CROSSING-1	810276.7417	1824338.937	810972.7102	1824108.114
CABLE CROSSING-2	811127.2129	1823386.359	811139.1141	1823393.167
CABLE CROSSING-3	811112.5	1823105	811163.784	1823096.388
CABLE CROSSING-4	810369.9284	1822929.64	810955.5386	1822913.194
CABLE CROSSING-5	810893.1777	1822787.587	810903.0783	1822736.626
CABLE CROSSING-6	809382.1463	1822907.845	810116.3221	1822909.683

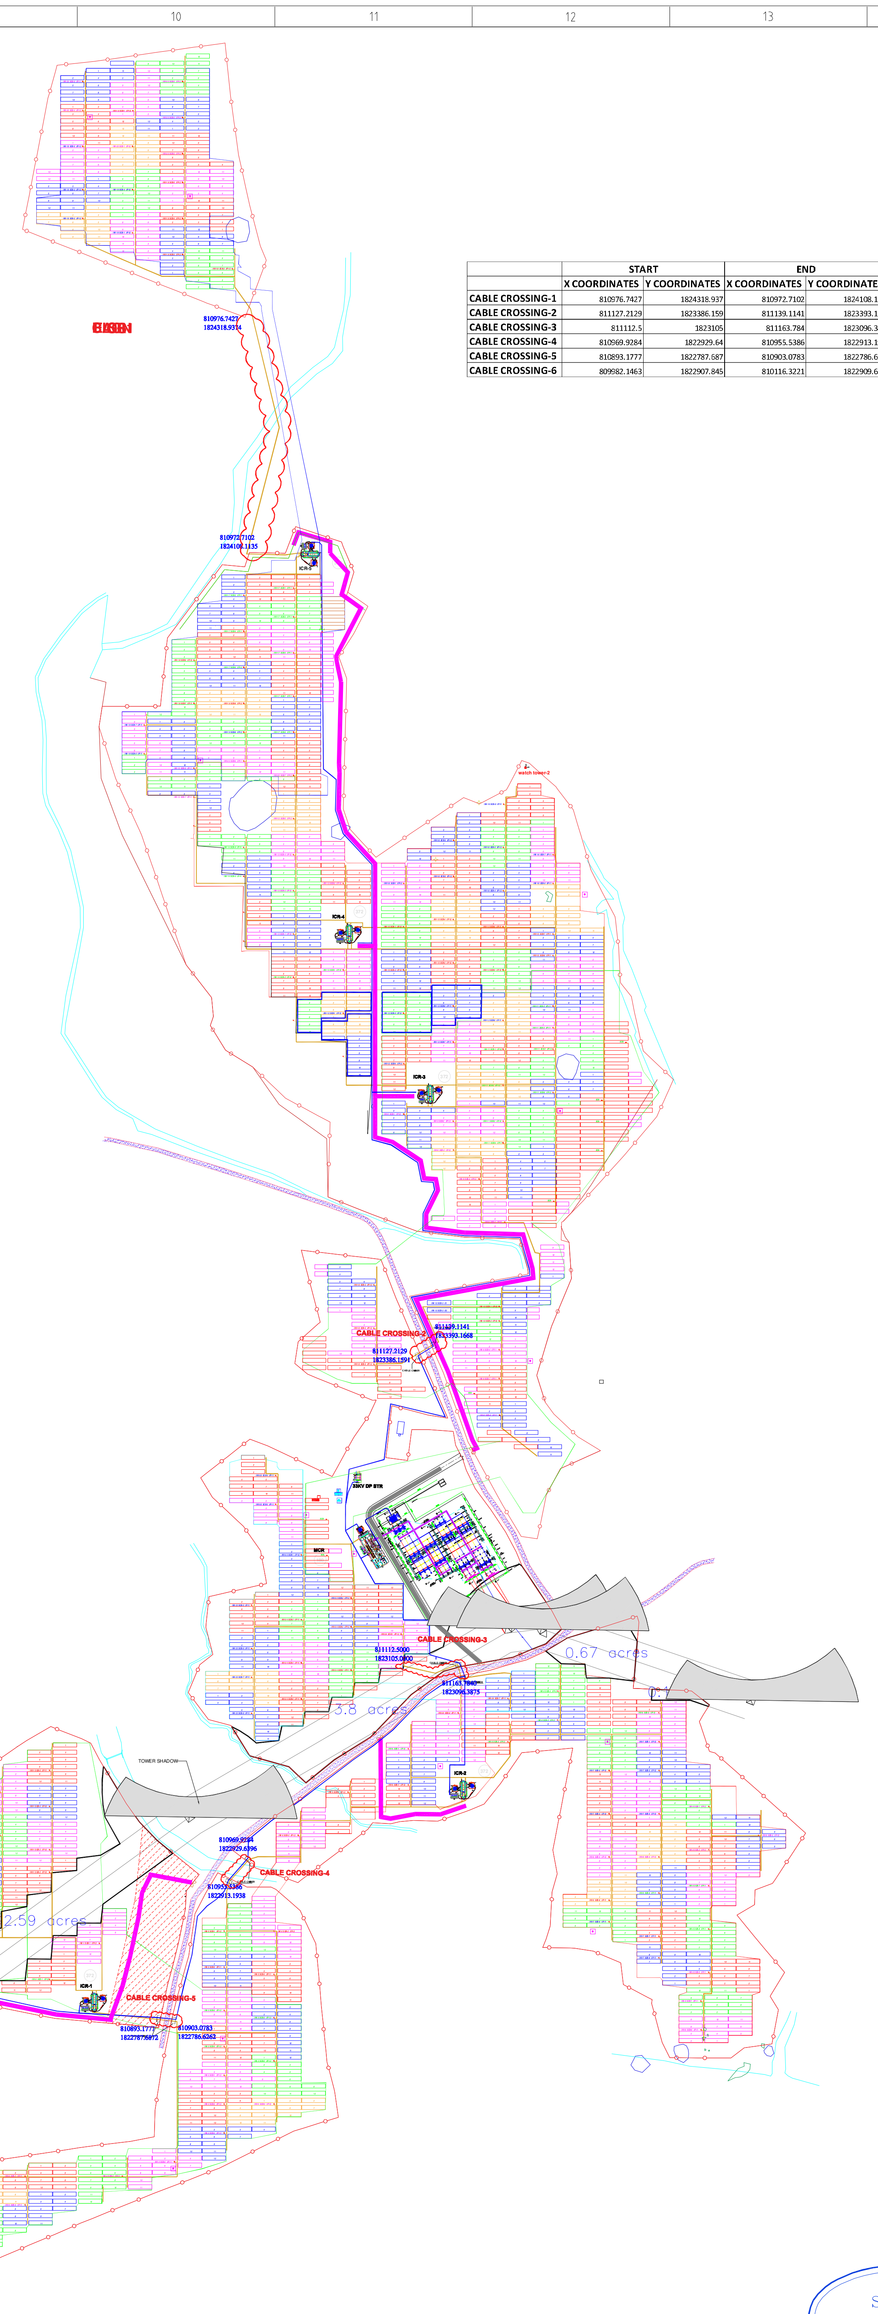

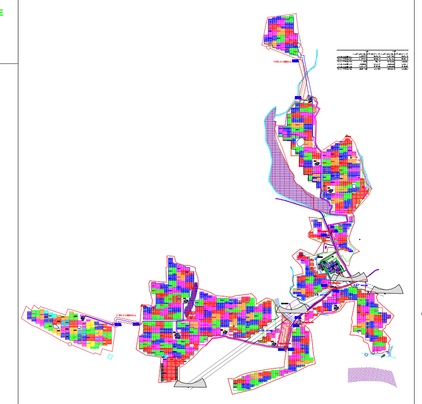

PLAN

LEGEND:-

SYMBOL	DESCRIPTION
	MMS(2x21) STRUCTURE
	4m WIDE ASPHALT ROAD
	4m WIDE WBM ROAD
	COMPOUND WALL / FENCING
	AC TRENCH
	DC TRENCH
	STRING COMBINER BOX(SCB)
	INVERTER CONTROL ROOM(ICR)
	MAIN CONTROL ROOM(MCR)

TECHNOLOGY:-

Module	Poly c-Si	
Inverter	1MW ABB Central Inverter	-39 no's
Inverter Transformer	2.0MVA, 33/2x0.38kV,3Wdg	- 19 no's
Inverter Transformer	1.0MVA, 33/0.38kV,3Wdg	- 1 no's
Power Transformer	50/55MVA, 220/33kV,2Wdg	- 1 no's
MV Switchboard	33kV AIS Switchgear Panel	
Evacuation S/S	220kV, AIS Switchyard	

PLANT DETAILS:-

GEO POSITION	N - 16°28'11.10" E - 77°54'59.67"
SITE AREA	175.168 ACRES
PV AREA	155 ACRES
INTER ROW	2.7
PITCH	6.5
MODULE ORIENTATION	SOUTH
TILT ANFGLE	15 DEG
DC CAPACITY	46.837 MWp
AC CAPACITY	39 MWac
NPR(DC/AC)	1.2
NO.OF MODULES	83958 (Talesun 310Wp) 54684 (Talesun 315Wp) 6904 (JA solar 315Wp) 2436 (JA solar 320Wp)
PV CONNECTORS	7142 - PLUG 7142- SOCKET
PV BRANCH CONNE.	3571 - PLUG 3571 - SOCKET
NO.OF TABLES	3571
TABLE TYPE	2x21, (PORTRAIT) 2x11, (PORTRAIT)
NO OF INV PER STN.	4 NOS.
NO OF TRANSFORMER PER STATION	2 NOS.

CHECK BOX

AS BUILT	FOR APPROVAL	INFORMATION ONLY	FOR CONSTRUCTION
√			

No.	DATE	REMARKS	DRN	CKED
R0	20-09-2018	AS BUILT	SB	AP

REVISIONS

PROJECT TITLE:
100MW SOLAR POWER PLANT
AT VELTOOR, TELANGANA

CLIENT:
TRANSFORM SUN ENERGY PRIVATE LIMITED

OWNERS CONSULTANT:
sgurr energy
A Wood Group Business

EPC CONTRACTOR:
STERLING & WILSON
NO.-4A/14, 6TH MAIN, CHIKKA ADUGODI,
NEW EXTENSION THAVAREKERE MAIN ROAD,
BANGALORE - 560 029.
PH : (080) 67178600 - 8609, E-MAIL :
swbirdesign@gmail.com

DRAWING TITLE:
OVERALL ARRAY LAYOUT - PLOT(BALEEDUPALLI)

DRAWING NO : SWLB-SP-TS-100MW-E-DWG-OAL-101		SCALE	NTS
DRAWN	RG	SHEET NO	1 OF 1
CHECKED	NK	PAPER SIZE	A1
APPROVED	SS	REV NO.	R0
DATE	26-09-17		