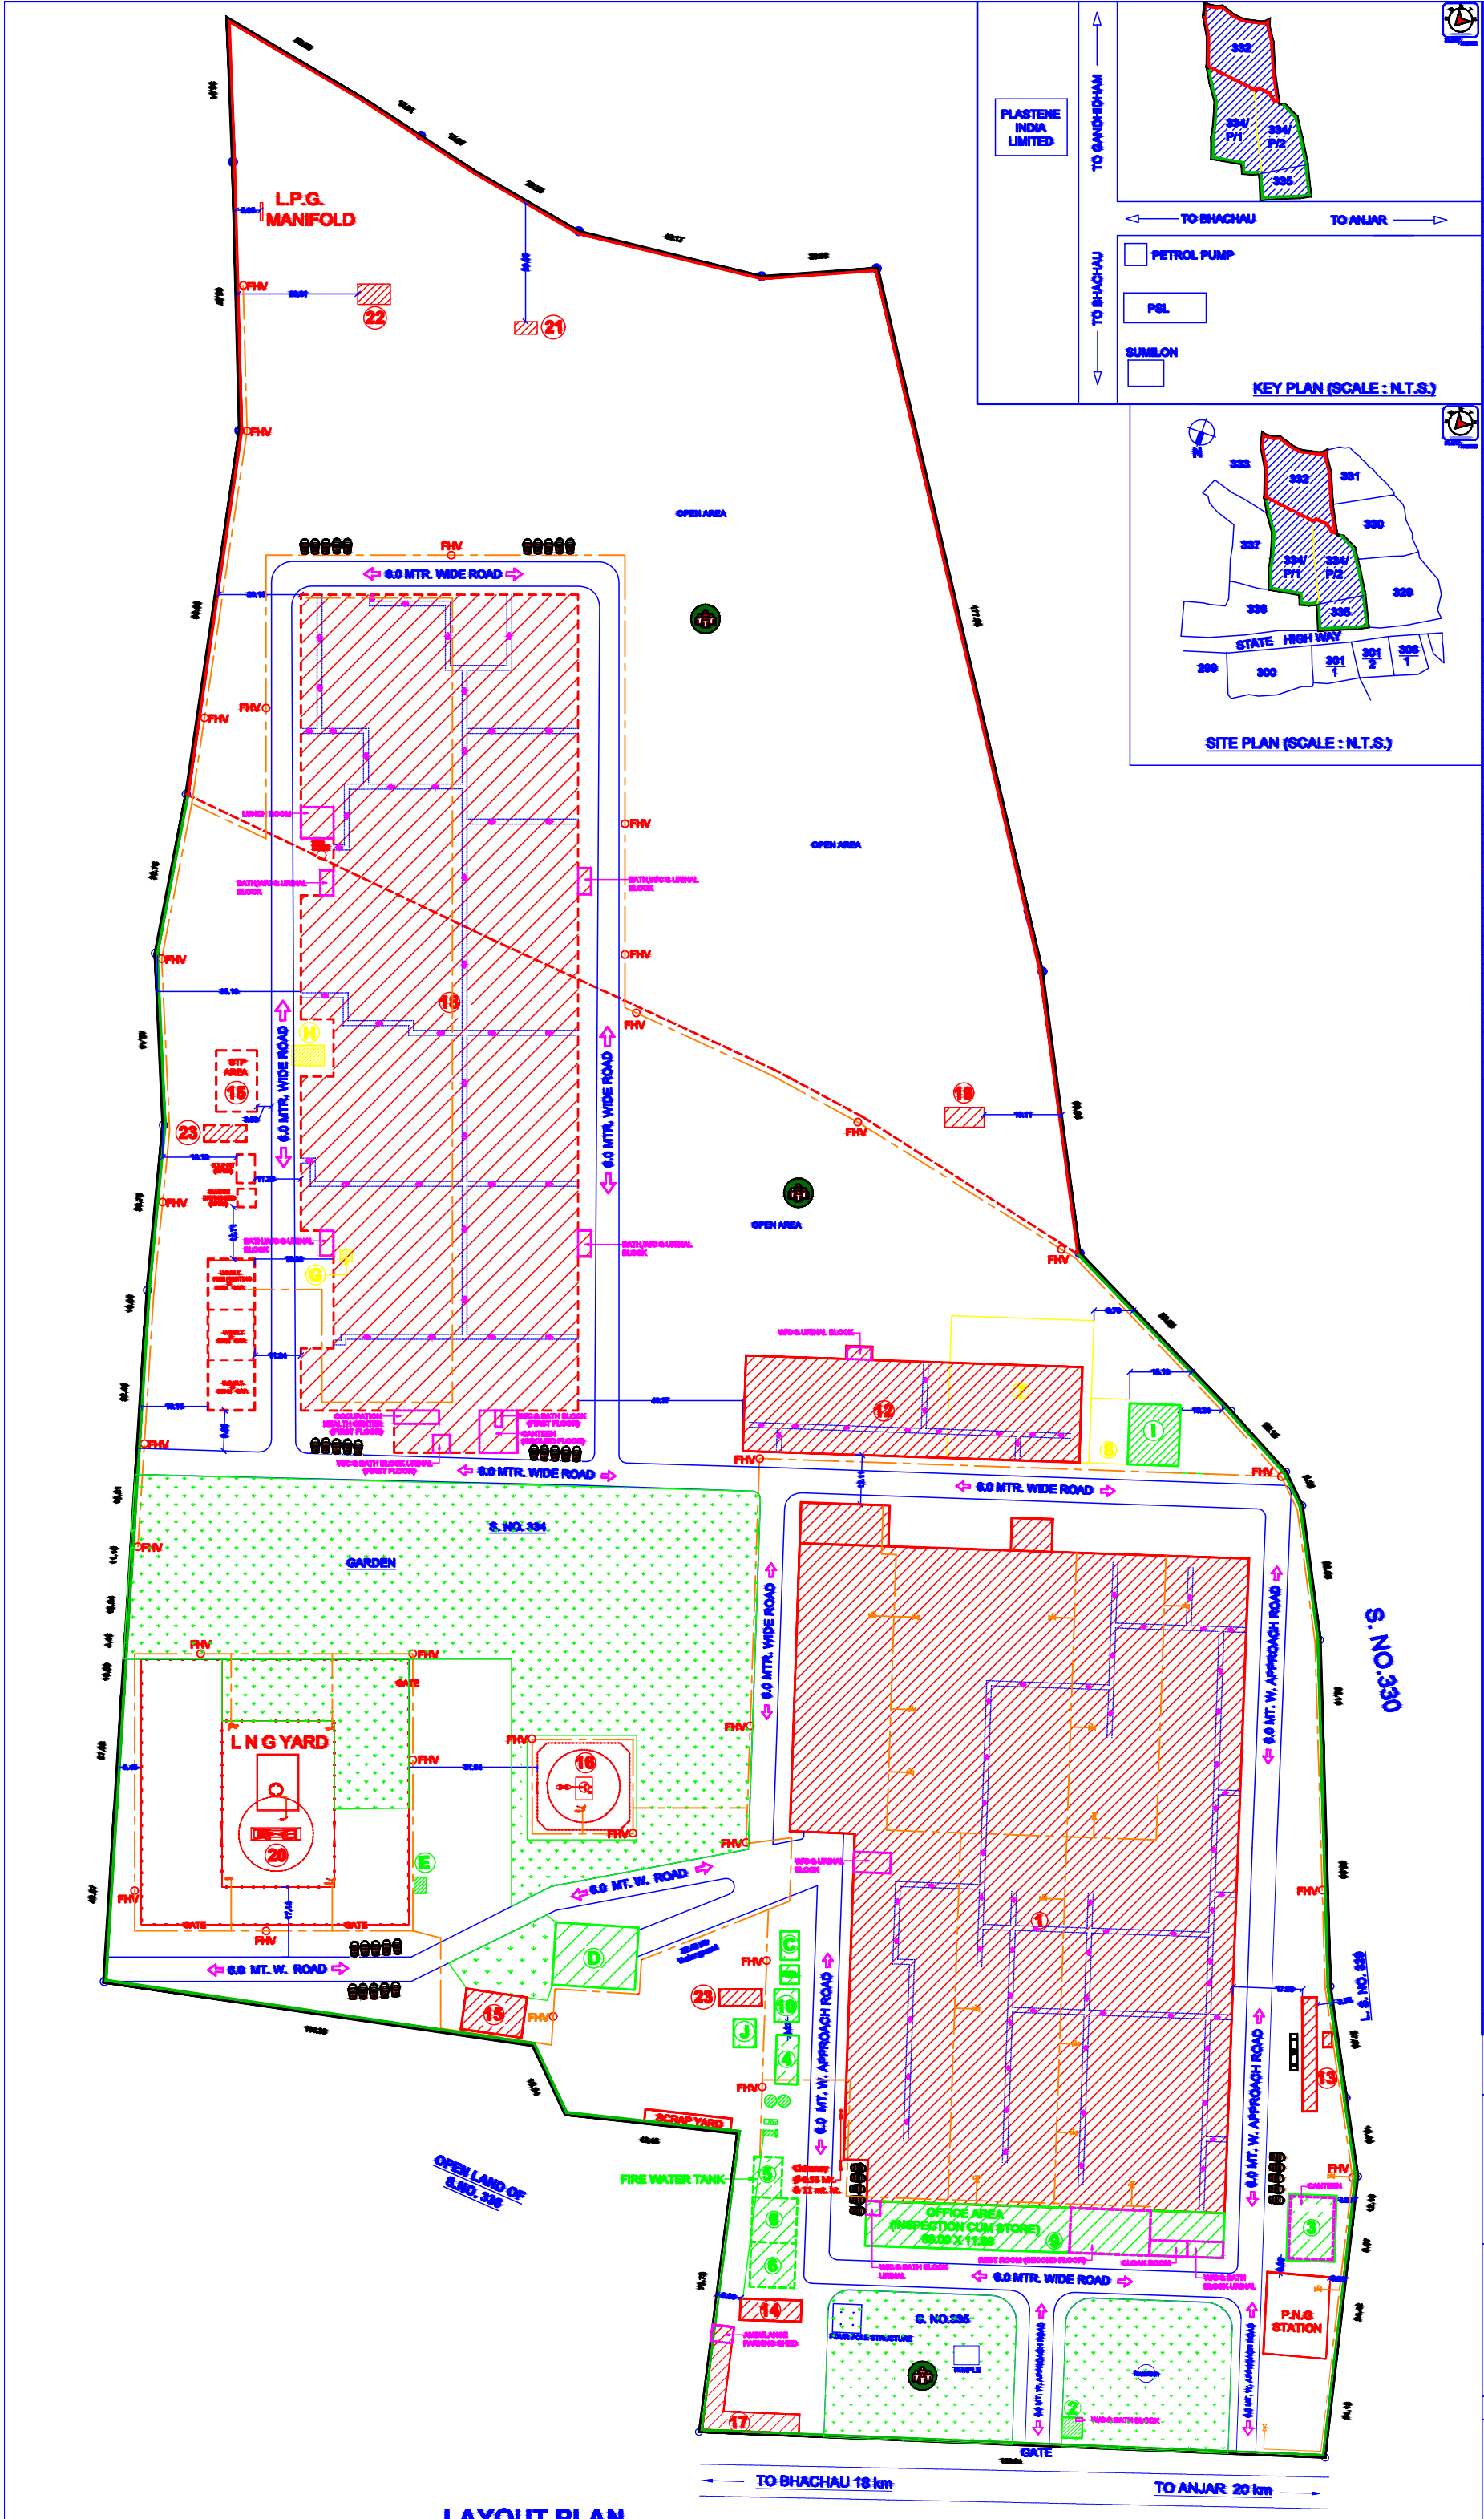

LAYOUT PLAN

KEY PLAN (SCALE : N.T.S.)

SITE PLAN (SCALE : N.T.S.)

SANCTIONED BY :-

01/05

PLANT NORTH

NOTE

ALL DIMENSIONS ARE IN METER UNLESS AND OTHERWISE SPECIFIED.

COLOR CODE

1.	APPROVED PORTION PROPOSED GIVEN IN BLACK + GREEN LINE.	
2.	APPROVED STRUCTURE GIVEN IN GREEN LINE.	
3.	TO BE APPROVED STRUCTURE GIVEN IN RED LINE.	
4.	PROPOSED STRUCTURE GIVEN IN RED DOT LINE.	
5.	FIRE HYDRANT LINE GIVEN IN ORANGE COLOR LINE.	
6.	SEWERING PROPOSED STRUCTURE GIVEN IN YELLOW LINE.	
7.	WALKING FACILITY GIVEN IN BLACK LINE	

THICKNESS OF PROPOSED WALL GIVEN IN RED COLOR LINE TO BE 230 MM

SYMBOL LEGEND

DUST BIN	EVACUATION ROUTE
SPITTOON	SAND BUCKET
FIRE EXTINGUISHER	WEIGHT BRIDGE
MACHINERY POINT	GREEN BELT
EXISTING TREE GIVEN	LADDER
EMERGENCY EXIT	WHEELS
FIRST AID BOX	TRUCK BAY
MACHINERY	MACHINERY RAILING

(WHERE MARGINE BETWEEN TWO MACHINE IS LESS THAN 1.00 METER)

AREA TABLE OF APPROVED STRUCTURES

S.NO.	NAME OF STRUCTURES	SIZE	AREA IN SQ.MTR.
1.	SECURITY CABIN	3.00 X 3.00	9.00
2.	CENTRAL WEIGHING BRIDGE	IRREGULAR	100.00
	WEIGH PANEL	IRREGULAR	10.00
4.	CHEMICAL STORE	12.00 X 6.00	72.00
5.	FIRE WATER TANK	10.00 X 7.00	70.00
6.	WATER TANK	20.00 X 10.00	200.00
7.	[illegible]	[illegible]	[illegible]
8.	[illegible]	[illegible]	[illegible]
9.	OFFICE AREA (INSPECTION CUM STORE) G.F. + F.F. + S.F.		1010.00
10.	STORE ROOM	[illegible]	40.00
11.	EFFLUENT TREATMENT FOUNDATION	4.00 X 7.00	28.00
12.	OIL/WATER/GREASE TANK SHED	10.00 X 10.00	100.00
13.	CENTRAL STORE	20.00 X 4.00	80.00
14.	[illegible]	[illegible]	[illegible]
15.	[illegible]	[illegible]	[illegible]
16.	[illegible]	[illegible]	[illegible]
17.	[illegible]	[illegible]	[illegible]
18.	LIQUID NITROGEN STORAGE TANK	10.00 X 10.00	100.00
19.	COOLING TOWER (CAPACITY 100 CUBIC MTR.)	6.00 X 6.00	36.00
	TOTAL BUILT-UP AREA OF APPROVED STRUCTURE		2287.41 SQ.M

AREA TABLE OF EXTENDED STRUCTURES

S.NO.	NAME OF STRUCTURES	SIZE	AREA IN SQ.MTR.
1.	MAIN PLANT BUILDING	IRREGULAR	7000.00
2.	PRE-WING	IRREGULAR	1000.00
3.	WEIGH BRIDGE	30.00 X 3.00	90.00
4.	CANTEEN	8.00 X 3.00	24.00
5.	STORE ROOM	15.00 X 5.00	75.00
6.	ETP PLANT (PRESENT WORK PROPOSED)	100.00 X 100.00 X 2	20000
7.	DISPENSING AREA	IRREGULAR	450.00
8.	PARKING SHED	IRREGULAR	300.00
9.	FACTORY SHED/ADMIN BUILDING G.F. + F.F. (PROPOSED)	IRREGULAR	14144.00
10.	STORAGE SHED	60.00 X 30.00	1800.00
11.	L.N.G. YARD	40.00 X 30.00	1200.00
12.	GENERATION ROOM	4.00 X 3.00	12.00
13.	SEWERING TOXI PIT	3.00 X 3.00	30.00
14.	SURSTING PIT & GENERATION ROOM (2 NOS. TYPE) 1- EXISTING & 1- PROPOSED	11.00 X 4.00 X 2	88.00
	TOTAL BUILT-UP AREA OF EXTENTED STRUCTURE = 32,241.44		SQ. MT.

APPLICATION	TITLE
REVISION & EXTENSION	BLOCK, SITE & KEY PLAN

PLAN SHOWING REVISION WITH EXTENSION FACTORY BUILDING ALONG WITH MACHINERY LAYOUT FOR **RAMA CYLINDER PVT LTD.** ON S. NO. 332,334/p/1,334/p/2 & 335 IN VILLAGE :- BHIMASAR, TALUKA :- ANJAR, DISTRICT : KUTCH.

APPLICANT :-

SIGNATURE WITH STAMP (OCCUPIER)

RAMA CYLINDER PVT. LTD.

CONSULTANT :-

B.J. CHAUHAN & ASSOCIATES
INDUSTRIAL CONSULTANT

Drawn :-	JAGDISH NAGDEVAR
Checked By :-	[illegible]
Subject :-	F.L. DRAWING
Date :-	10 / MAY / 2020
Scale :-	1:250
Dwg. No. :-	[illegible]